



**BUILDING CODE COMPLIANCE OFFICE (BCCO)
PRODUCT CONTROL DIVISION**

**MIAMI-DADE COUNTY, FLORIDA
METRO-DADE FLAGLER BUILDING
140 WEST FLAGLER STREET, SUITE 1603
MIAMI, FLORIDA 33130-1563
(305) 375-2901 FAX (305) 375-2908**

NOTICE OF ACCEPTANCE (NOA)

**Andersen Corporation
100 Fourth Ave. North
Bayport, MN 55003-1096**

SCOPE:

This NOA is being issued under the applicable rules and regulations governing the use of construction materials. The documentation submitted has been reviewed by Miami-Dade County Product Control Division and accepted by the Board of Rules and Appeals (BORA) to be used in Miami Dade County and other areas where allowed by the Authority Having Jurisdiction (AHJ).

This NOA shall not be valid after the expiration date stated below. The Miami-Dade County Product Control Division (In Miami Dade County) and/or the AHJ (in areas other than Miami Dade County) reserve the right to have this product or material tested for quality assurance purposes. If this product or material fails to perform in the accepted manner, the manufacturer will incur the expense of such testing and the AHJ may immediately revoke, modify, or suspend the use of such product or material within their jurisdiction. BORA reserves the right to revoke this acceptance, if it is determined by Miami-Dade County Product Control Division that this product or material fails to meet the requirements of the applicable building code.

This product is approved as described herein, and has been designed to comply with the High Velocity Hurricane Zone of the Florida Building Code.

DESCRIPTION: Series FWG "Frenchwood Gliding" Wood Sliding Glass Door

APPROVAL DOCUMENT: Drawing No. **DADE-FWG-IMPACT**, titled "UNIT, FWG – IMPACT", sheets 1 through 4 of 4, dated 2/19/00 with revision B dated 4/25/00, prepared by the manufacturer, bearing the Miami-Dade County Product Control Renewal stamp with the Notice of Acceptance number and expiration date by the Miami-Dade County Product Control Division.

MISSILE IMPACT RATING: Large and Small Missile Impact

LABELING: Each unit shall bear a permanent label with the manufacturer's name or logo, city, state and following statement: "Miami-Dade County Product Control Approved", unless otherwise noted herein.

RENEWAL of this NOA shall be considered after a renewal application has been filed and there has been no change in the applicable building code negatively affecting the performance of this product.

TERMINATION of this NOA will occur after the expiration date or if there has been a revision or change in the materials, use, and/or manufacture of the product or process. Misuse of this NOA as an endorsement of any product, for sales, advertising or any other purposes shall automatically terminate this NOA. Failure to comply with any section of this NOA shall be cause for termination and removal of NOA.

ADVERTISEMENT: The NOA number preceded by the words Miami-Dade County, Florida, and followed by the expiration date may be displayed in advertising literature. If any portion of the NOA is displayed, then it shall be done in its entirety.

INSPECTION: A copy of this entire NOA shall be provided to the user by the manufacturer or its distributors and shall be available for inspection at the job site at the request of the Building Official.

This NOA **renews NOA # 00-1011.08** and consists of this page 1 as well as approval document mentioned above. The submitted documentation was reviewed by **Manuel Perez, P.E.**



**NOA No 03-0415.17
Expiration Date: June 22, 2008
Approval Date: May 15, 2003
Page 1**

Andersen Corporation

NOTICE OF ACCEPTANCE: EVIDENCE SUBMITTED

(For File ONLY. Not part of NOA)

A. DRAWINGS

1. Manufacturer's die drawings and sections.
2. Drawing No. **DADE-FWG-IMPACT**, titled "UNIT, FWG – IMPACT", sheets 1 through 4 of 4, dated 2/19/00 with revision B dated 4/25/00, prepared by the manufacturer.

B. TESTS

Submitted under NOA#00-1011.08

1. Test reports on 1) Air Infiltration Test, per FBC, TAS 202-94
2) Uniform Static Air Pressure Test, Loading per FBC, TAS 202-94
3) Water Resistance Test, per FBC, TAS 202-94
4) Large Missile Impact Test per FBC, TAS 201-94
5) Cyclic Wind Pressure Loading per FBC, TAS 203-94
6) Forced Entry Test, per FBC 2411 3.2.1 and TAS 202-94
along with marked-up drawings and installation diagram of a wood sliding glass door, prepared by Architectural Testing Inc., Test Report No. **ATI-02-31214.01**, dated 04/28/99, with addendum letter dated 05/12/2000, all signed and sealed by Allen N. Reeves, P.E.

C. CALCULATIONS

1. Anchor calculations and comparative analysis, dated 4/09/03.

Submitted under NOA#00-1011.08

2. Fastener Installation Analysis Report, Project #99-0208, dated February 19, 1999, with revision #1 dated May 19, 2000, prepared, signed and sealed by Richard Boyette, P.E.

D. MATERIAL CERTIFICATIONS


1. Notice of Acceptance No. **02-0828.15** issued to E. I. Dupont DeNemours., for "Dupont Butacite ® PVB", approved on 11/21/02 expiring on 12/11/05.
2. Notice of Acceptance No. **01-1205.02**, issued to Solutia Inc., for "Saflex / Keepsafe Maximum", approved on 5/17/01 expiring on 05/21/06.

E. STATEMENTS

1. Statement letter of no change, issued by Andersen Corporation, signed by Chris Richner, dated 4/10/03.


F. OTHER

1. Notice of Acceptance No. **00-1011.08** issued to Andersen Corporation, for their Series FWG "Frenchwood Gliding" Wood Sliding Glass Door, approved on 06/07/2001 and expiring on 06/22/2003.

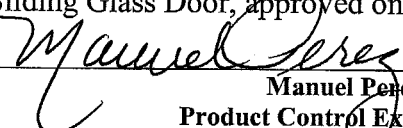
Manuel Perez, P.E.
Product Control Examiner
NOA No 03-0415.17


Expiration Date: June 22, 2008

Approval Date: May 15, 2003

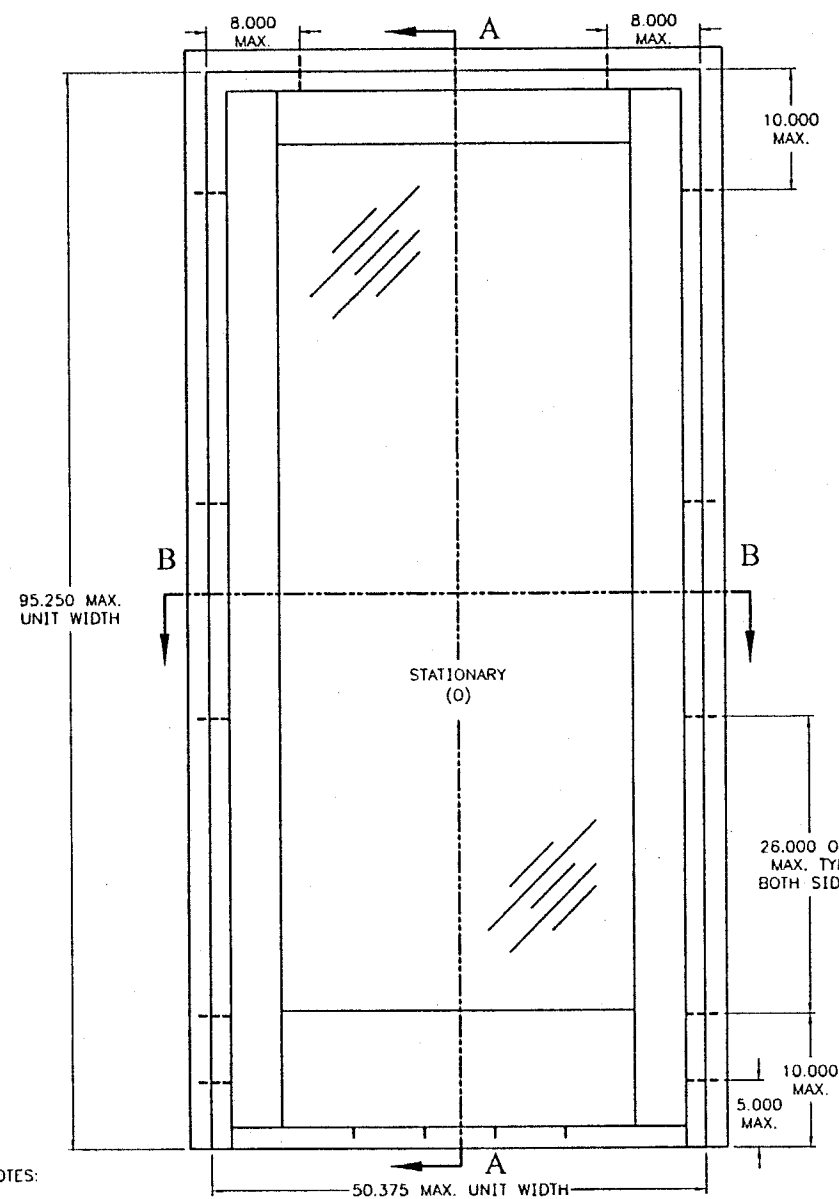

FWG-4380	+50/-63
FWG-3380	+50/-63
FWG-2980	+50/-63
FWG-43611	+50/-63
FWG-33611	+50/-63
FWG-29611	+50/-63
FWG-4368	+50/-63
FWG-3368	+50/-63
FWG-2968	+50/-63
UNIT DES.	DP RATINGS (PSF)

SIDLIGHT

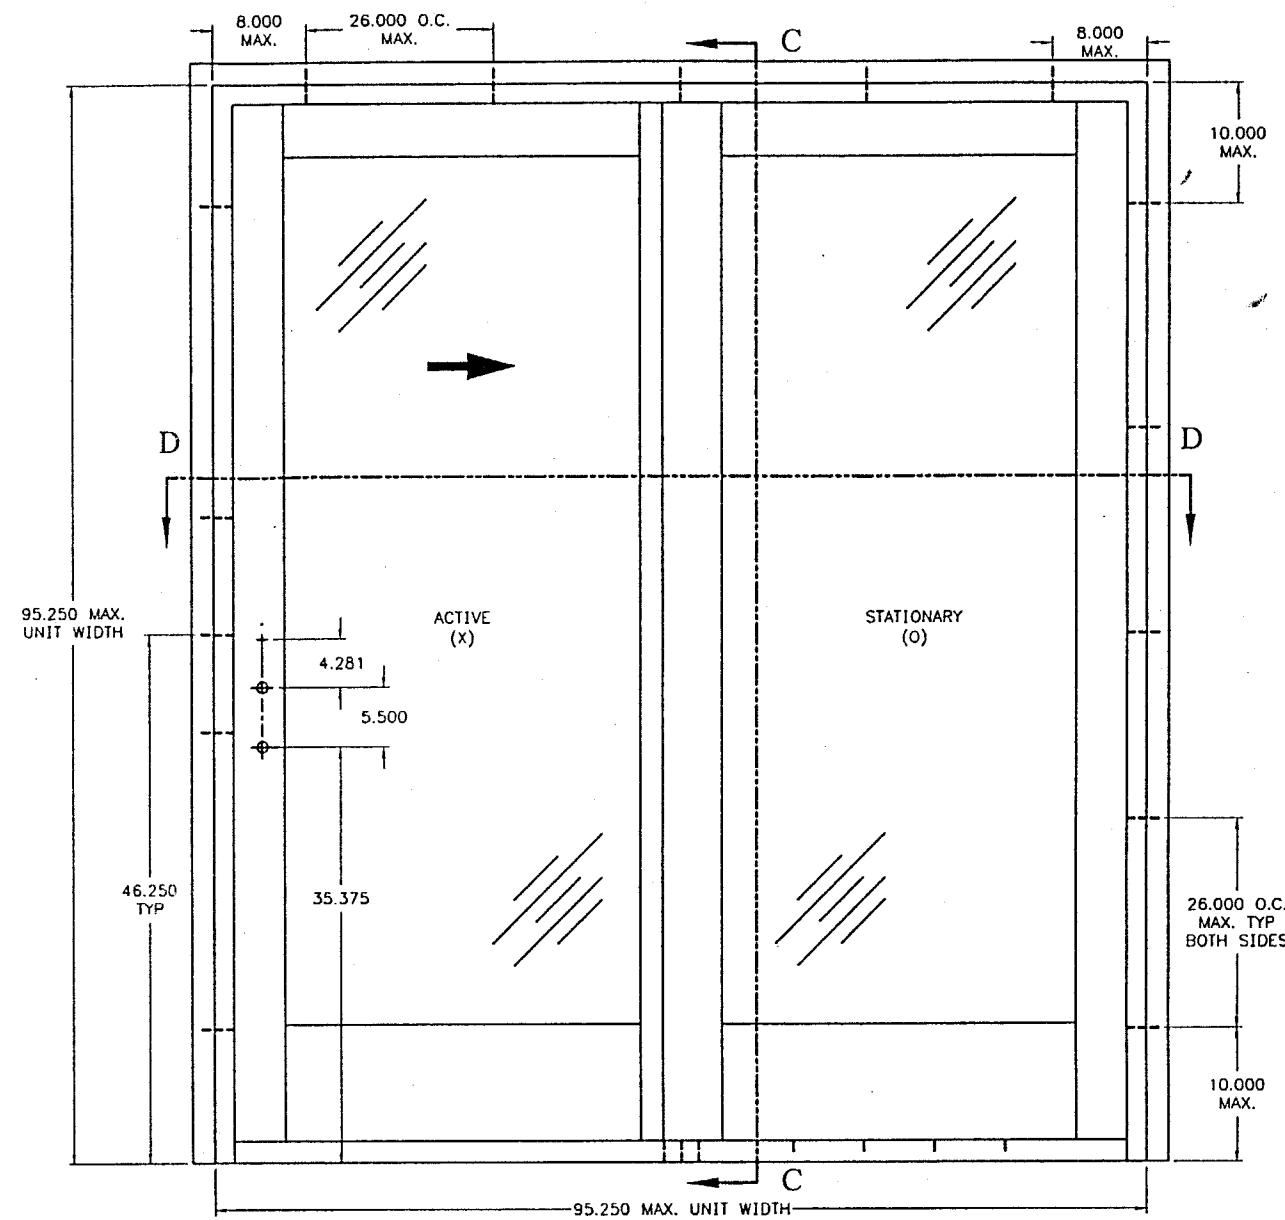

FWG-8080	+45/-60
FWG-6080	+45/-60
FWG-5080	+45/-60
FWG-80611	+45/-60
FWG-60611	+45/-60
FWG-50611	+45/-60
FWG-8068	+45/-60
FWG-6068	+45/-60
FWG-5068	+45/-60
UNIT DES.	DP RATINGS (PSF)

2 PANEL

NOTES:



1. INSTALLATION METHODS:
WOOD BUCK: THE SILL IS SET IN SILICONE BACK BEDDING AND THE 2 PANEL SILLS ARE SECURED WITH THREE #10 X 2-1/2" WOOD SCREWS OR TAPCONS.
THE JAMBS ARE SECURED WITH FOUR OR FIVE #10 X 2-1/2" WOOD SCREWS OR TAPCONS THROUGH EACH JAMB INTO OPENING.
THE HEAD IS SECURED WITH TWO TO FIVE #10 X 2-1/2" WOOD SCREWS OR TAPCONS THROUGH HEAD INTO OPENING SPACED 8" FROM EACH JAMB AND 26" O.C. MAX.
MASONRY: TAPCON SPACING AND LOCATION IS THE SAME AS WOOD SCREW SPACING AND LOCATION.
2. GLAZING SPECIFICATIONS:
HEAT STRENGTHENED: THE UNITS UTILIZE 3/8" THICK LAMINATED GLASS FABRICATED & COMPOSED OF TWO NOMINAL 5/32" HEAT STRENGTHENED SHEETS WITH A .090" PVB GRAY OR CLEAR INNER LAYER MANUFACTURED BY DUPONT OR SOLUTIA.
ANNEALED: THE UNITS UTILIZE 17/32" (.532) NOMINAL THICK LAMINATED GLASS FABRICATED & COMPOSED OF TWO NOMINAL 7/32" ANNEALED SHEETS WITH A .090" GRAY OR CLEAR PVB INNER LAYER MANUFACTURED BY DUPONT OR SOLUTIA.
GLAZING METHOD:
GLASS IS SET FROM THE INTERIOR AGAINST ONE OR TWO COMPONENT SILICONE BEDDING AND THEN THE GLASS IS BACKGLAZED WITH SILICONE, WOOD STOPS ARE USED ON THE INTERIOR, SECURED WITH 1-1/2" FINISHING NAILS SPACED 8" ON CENTER.
3. GLASS BITE = .563".
4. FRAME CONSTRUCTION:
CORNERS ARE COPED, BUTTED, GLUED & FASTENED USING FOUR #10 X 2-1/2" WOOD SCREWS PER HEAD JAMB CORNER AND THREE #10 X 2-1/2" WOOD SCREWS PER SILL JAMB CORNER. THE SILL FILLER BELOW THE STATIONARY PANEL IS REINFORCED WITH THREE OR FOUR 2" & 3/8" RIBBED ALUMINUM ANGLES (RETAINING BLOCK) POSITIONED 2", 24", 42" & 46" FROM FRAME JAMB AND IS SECURED TO THE SILL WITH SIX .250" X .750" BOLTS.
5. PANEL CONSTRUCTION:
THE WOOD PANELS CONTAIN BLIND MORTISE AND TENON, DOWEL, SECURED AND GLUED CORNER CONSTRUCTION. THE STATIONARY PANEL IS SECURED TO THE FRAME WITH FOUR OR SIX #8 X 1" SCREWS THROUGH THE SILL INSERT FLANGE INTO PANEL. THE TOP RAIL OF THE STATIONARY PANEL IS SECURED TO THE FRAME WITH A 1-3/4" X 1-5/8" ANGLE METAL BRACKET. THE BRACKET IS SECURED WITH TWO #8 X 1" SCREWS INTO THE PANEL & THREE #8 X 1" SCREW INTO THE FRAME.
THE OPERATING PANEL WAS HELD IN THE GUIDE TRACK USING A 1/2" X 1/2" WOOD/VINYL GLIDE STOP WHICH WAS SECURED TO THE FRAME WITH #8 X 1-1/2" LONG SCREWS SPACED 8" ON CENTER.
6. WEATHERSTRIPPING:
.531" VINYL FLAP, 2 ROWS AT MEETING STILES, ONE ROW EACH STILE. .275" VINYL LEAF, ONE ROW AT STATIONARY PANEL JAMB & HEAD. .250" DIAMETER VINYL BULB, ONE ROW AT OPERATING PANEL MEETING STILE.

PRODUCT RENEWED
as complying with the Florida
Building Code
Acceptance No. 03-0415.17
Expiration Date: JUNE 22, 2008
By: *M. M. M. M.*
Miami Dade Product Control
Division

APPROVED AS COMPLYING WITH THE
SOUTH FLORIDA BUILDING CODE
DATE: JUN 07 2001
BY: *M. M. M. M.*
PRODUCT CONTROL DIVISION
BUILDING CODE COMPLIANCE OFFICE
ACCEPTANCE NO. 00-1011.08

TITLE UNIT, FWG - IMPACT	
Andersen Corporation Bayport, Minnesota 55003	
THESE DRAWINGS ARE PROVIDED AS A SERVICE BY ANDERSEN CORPORATION FOR THE BENEFIT OF ITS CUSTOMERS. FINAL RESPONSIBILITY FOR ACCURACY OF DESIGN, FINAL SPECIFICATIONS, DRAWINGS AND FOR THE ACTUAL INSTALLATION SUGGESTED BY THESE DRAWINGS LIES WITH THE ARCHITECT, ENGINEER AND/OR CONTRACTOR.	
COPYRIGHT ANDERSEN CORPORATION 1998. ALL RIGHTS RESERVED.	
APPROVE/DATE 2/19/00	DRAWING NUMBER DADE-FWG-IMPACT
SHT. 1 OF 4	

B 4/25/00
A 2/19/99
REVISION

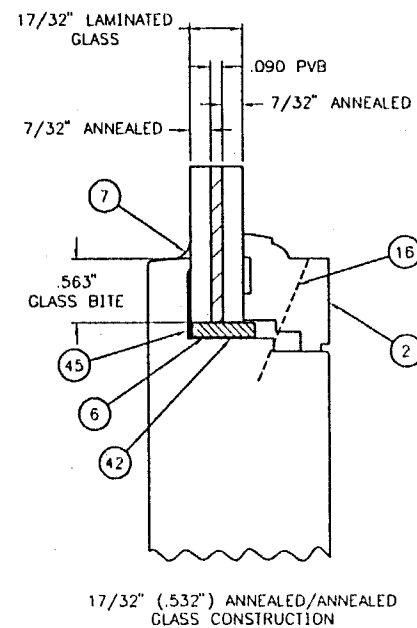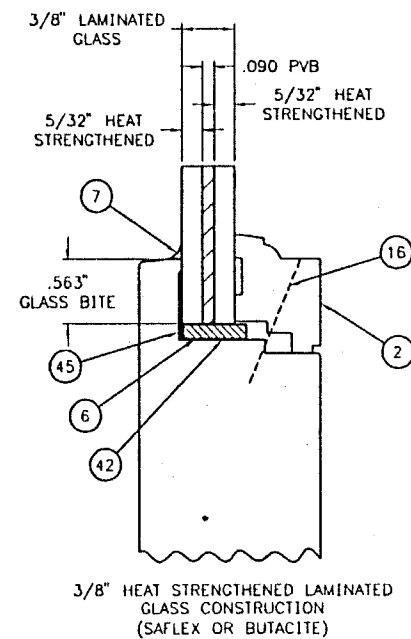

FWG-8080	48.000	92.141
FWG-6080	36.000	92.141
FWG-5080	30.000	92.141
FWG-80611	48.000	79.016
FWG-60611	36.000	79.016
FWG-50611	30.000	79.016
FWG-8068	48.000	76.141
FWG-6068	36.000	76.141
FWG-5068	30.000	76.141
FWG-4380	48.000	92.141
FWG-3380	36.000	92.141
FWG-2980	30.000	92.141
FWG-43611	48.000	79.016
FWG-33611	36.000	79.016
FWG-29611	30.000	79.016
FWG-4368	48.000	76.141
FWG-3368	36.000	76.141
FWG-2968	30.000	76.141
UNIT DES.	WIDTH	HEIGHT

PANEL DIMENSIONS

FWG-8080	95.250	95.500
FWG-6080	71.250	95.500
FWG-5080	59.250	95.500
FWG-80611	95.250	82.375
FWG-60611	71.250	82.375
FWG-50611	59.250	82.375
FWG-8068	95.250	79.500
FWG-6068	71.250	79.500
FWG-5068	59.250	79.500
FWG-4380	50.000	95.500
FWG-3380	38.000	95.500
FWG-2980	32.000	95.500
FWG-43611	50.000	82.375
FWG-33611	38.000	82.375
FWG-29611	32.000	82.375
FWG-4368	50.000	79.500
FWG-3368	38.000	79.500
FWG-2968	32.000	79.500
UNIT DES.	WIDTH	HEIGHT

UNIT DIMENSIONS

FWG-8080	5	5
FWG-6080	5	3
FWG-5080	5	3
FWG-80611	4	5
FWG-60611	4	3
FWG-50611	4	3
FWG-8068	4	5
FWG-6068	4	3
FWG-5068	4	3
FWG-4380	5	2
FWG-3380	5	2
FWG-2980	5	2
FWG-43611	4	2
FWG-33611	4	2
FWG-29611	4	2
FWG-4368	4	2
FWG-3368	4	2
FWG-2968	4	2
UNIT DES.	# OF SCREWS THROUGH EACH JAMB	# OF SCREWS THROUGH HEAD JAMB

-	BEAD	SILICONE	ATTACHMENT OF SIDE JAMBS TO HEAD JAMB
40	1	BRACKET	ATTACHMENT OF STATIONARY PANEL TO FRAME
36	6-12	SCREWS, #8 X 1.500"	ATTACHMENT OF INSIDE STOP TO HEAD JAMB
37	5	SCREWS, #8 X 1.000"	ATTACHMENT OF BRACKET TO STATIONARY PANEL & HEAD JAMB
37	12-14	SCREWS, #8 X 1.000"	ATTACHMENT OF SILL FILLER TO BOTTOM RAIL
49	10-12	SCREWS, #8 X 0.750"	ATTACHMENT OF SIDE STOP TO SIDE JAMB (SIDELIGHT)
37	4-6	SCREWS, #8 X 1.000"	ATTACHMENT OF STATIONARY PANEL TO FILLER
18	14	SCREWS, #10 X 2.500"	ATTACHMENT OF SIDE JAMBS TO HEAD JAMBS AND SILL
50	4	SCREWS, #10 X 0.375"	ATTACHMENT OF RETAINING BLOCK SILL (1 PER BLOCK)
48	6	BOLT, 0.250" X 0.750"	ATTACHMENT OF SILL FILLER TO SILL
17	8-10	NAIL, FINISH 4D 1.500"	ATTACHMENT OF TRIM TO SIDE JAMB
ITEM #	QTY.	DESCRIPTION	LOCATION

FRAME FASTENERS LIST

45	BEAD	SILICONE	ATTACHMENT OF GLASS TO STILES & RAILS (BACK GLAZING)
42	BEAD	SILICONE	ATTACHMENT OF GLASS TO STILES & RAILS (BED GLAZING)
7	BEAD	SILICONE	EXTERNAL FILLET BETWEEN GLASS & PANEL SURROUND
16	20	NAIL, FINISH 1.500"	ATTACHMENT OF INSIDE GLASS STOP TO STILES
16	12	NAIL, FINISH 1.500"	ATTACHMENT OF INSIDE GLASS STOP TO RAILS
-	2	DOWEL, Ø.438 X 6.500"	ATTACHMENT OF BOTTOM RAIL TO STILES
-	2	DOWEL, Ø.438 X 5.000"	ATTACHMENT OF TOP RAIL TO STILES
-	6	SCREWS, #10 X 5.000"	ATTACHMENT OF STILES TO RAILS (STATIONARY ONLY)
38	11	SCREWS, #7 X 0.625"	ATTACHMENT OF STATIONARY INTERLOCK W/S TO PANEL
ITEM #	QTY.	DESCRIPTION	LOCATION

STATIONARY PANEL FASTENERS LIST

45	BEAD	SILICONE	ATTACHMENT OF GLASS TO STILES & RAILS (BACK GLAZING)
42	BEAD	SILICONE	ATTACHMENT OF GLASS TO STILES & RAILS (BED GLAZING)
7	BEAD	SILICONE	EXTERNAL FILLET BETWEEN GLASS & PANEL SURROUND
16	20	NAIL, FINISH 1.500"	ATTACHMENT OF INSIDE GLASS STOP TO STILES
16	12	NAIL, FINISH 1.500"	ATTACHMENT OF INSIDE GLASS STOP TO RAILS
17	8-10	NAIL, FINISH 4D 1.500"	ATTACHMENT OF TRIM TO STILE
-	2	DOWEL, Ø.438 X 6.500"	ATTACHMENT OF BOTTOM RAIL TO STILES
-	2	DOWEL, Ø.438 X 5.000"	ATTACHMENT OF TOP RAIL TO STILES
37	14	SCREWS, #8 X 1.000"	ATTACHMENT OF BOTTOM RAIL FILLER TO PANEL
38	11	SCREWS, #7 X 0.625"	ATTACHMENT OF OPERATOR INTERLOCK W/S TO PANEL
ITEM #	QTY.	DESCRIPTION	LOCATION

ACTIVE PANEL FASTENERS LIST

51	1/4" DIAMETER TAPCON	-	STEEL	-	-
50	SCREW, #10 X .375"	-	STEEL	0.375	0.134
49	SCREW, #8 X .750"	-	STEEL	-	-
48	BOLT, .250" X .750"	-	STEEL	0.250	0.750
47	JAMB, SIDE, SIDE LIGHT ASSEMBLY	50289	PINE/VINYL	1.375	5.875
46	STOP, OUTSIDE SIDE LIGHT	50231	ALUMINUM	0.438	1.031
45	SEALANT (DC 983-2 / DC 3-0117)	MDS0012/33	SILICONE	-	-
44	JAMB, HEAD	51006	PINE	5.875	1.375
43	PARTING STOP BRACKET	51051	ALUMINUM	0.632	6.000
42	SEALANT (DC 983-2) / (DC9-1350)	MDS0012/42	SILICONE	-	-
41	SCREWS, #8 X 1" FLAT HD	3620910	STEEL	-	-
40	BRACKET	51173	STEEL	1.718	1.657
39	.250" DIAMETER SILICONE BULB	51019	SILICONE	-	-
38	SCREW, #7 X .625"	3621100	STEEL	-	-
37	SCREW, #8 X 1.000"	3621110	STEEL	-	-
36	SCREW, #8 X 1.500"	3621250	STEEL	-	-
35	FLANGE, HEAD	50061	VINYL	-	-
34	CUTIE, SCREEN	50101	VINYL	1.125	0.988
33	FLASHING, HEAD	50053	ALUMINUM	1.312	1.335
32	STOP, HEAD PARTING	51039	VINYL	1.030	0.391
31	STOP, HEAD INSIDE	51036	PINE/VINYL	0.765	0.719
30	RAIL, TOP STATIONARY	51021	PINE	4.438	1.719
29	RAIL, TOP OPERATING	51021	PINE	4.438	1.719
28	STOP, GLAZING RAILS	51195	PINE	0.500	0.875
27	RAIL, BOTTOM RAIL STATIONARY	51020	PINE	8.594	1.719
26	RAIL, BOTTOM RAIL OPERATING	51020	PINE	8.594	1.719
25	ASSEMBLY, WHEEL	51052	STEEL	-	-
24	FILLER, BOTTOM RAIL OPERATING	51050	VINYL	1.855	0.931
23	BLOCK, RETAINING	51013	ALUMINUM	-	-
22	FILLER, SILL	51203	VINYL	2.300	1.774
21	SILL, INSIDE PIECE	50095	ALUMINUM	1.937	1.164
20	SILL, OUTSIDE PIECE	50154	ALUMINUM	0.448	3.297
19	BREAK, THERMAL SILL	50354	VINYL	1.888	1.938
18	WOOD SCREW, #10 X 2.500" OR TAPCON	3620470	STEEL	-	-
17	NAIL, FINISH 4D	-	STEEL	-	-
16	NAIL, FINISH 1.500"	20093	STEEL	-	-
15	PLATE, STRIKE	2573562	STEEL	-	-
14	INTERLOCK, OPERATING	51019	VINYL	0.738	1.925
13	INTERLOCK, STATIONARY	51148	VINYL	0.738	1.144
12	LOCK, REACH OUT	2573588	STEEL	-	-
11	JAMB, OPERATING SIDE	50022	PINE	5.875	1.375
10	JAMB, STATIONARY SIDE	50017	PINE	5.875	1.375
9	TRIM, JAMB	51151	PINE	3.141	0.344
8	HANDLE	2573514-5	BRASS	-	-
7	SEALANT (DC 791)	MDS0034/35/36	SILICONE	-	-
6	SPACER, GLASS	20065	VINYL	0.375	1.000
5	GLASS, LAMINATED	04170	-	-	-
4	STILE, SIDE	51022	LVL	4.438	1.719
3	TRIM, STILE	51152	PINE	2.000	0.367
2	STOP, GLAZING SIDE	51196	PINE	0.500	0.875
1	FLANGE, SIDE	50347	VINYL	1.644	0.430
ITEM #	DESCRIPTION	PART	MATERIAL	HEIGHT	WIDTH

DRAWING REFERENCE LIST


ALL PARTS MANUFACTURED TO ANDERSEN SPECIFICATION
AS NOTED BY ABOVE PART NUMBERS

APPROVED AS COMPLYING WITH THE
SOUTH FLORIDA BUILDING CODE
DATE JUN 07 2007
BY *W. Paul Perry*
PRODUCT CONTROL DIVISION
BUILDING CODE COMPLIANCE OFFICE
ACCEPTANCE NO. 00-1011.08

PRODUCT RENEWED
as complying with the Florida
Building Code
Acceptance No. 03-0415.17
Expiration Date JUNE 22, 2008
By *W. Paul Perry*
Miami Code Product Control
Division


B 4/25/00
A 2/19/99
REVISION

TITLE	
UNIT, FWG - IMPACT	
Andersen Corporation Bayport, Minnesota 55003	
THESE DRAWINGS ARE PROVIDED AS A SERVICE BY ANDERSEN CORPORATION FOR THE BENEFIT OF ITS CUSTOMERS. FINAL RESPONSIBILITY FOR ACCURACY OF DESIGN, FINAL SPECIFICATIONS, DRAWINGS AND FOR THE ACTUAL INSTALLATION SUGGESTED BY THESE DRAWINGS LIES WITH THE ARCHITECT, ENGINEER AND/OR CONTRACTOR.	
COPYRIGHT ANDERSEN CORPORATION 1998. ALL RIGHTS RESERVED.	
APPROVE/DATE	DRAWING NUMBER
2/19/00	DADE-FWG-IMPACT
SHT. 2 OF 4	

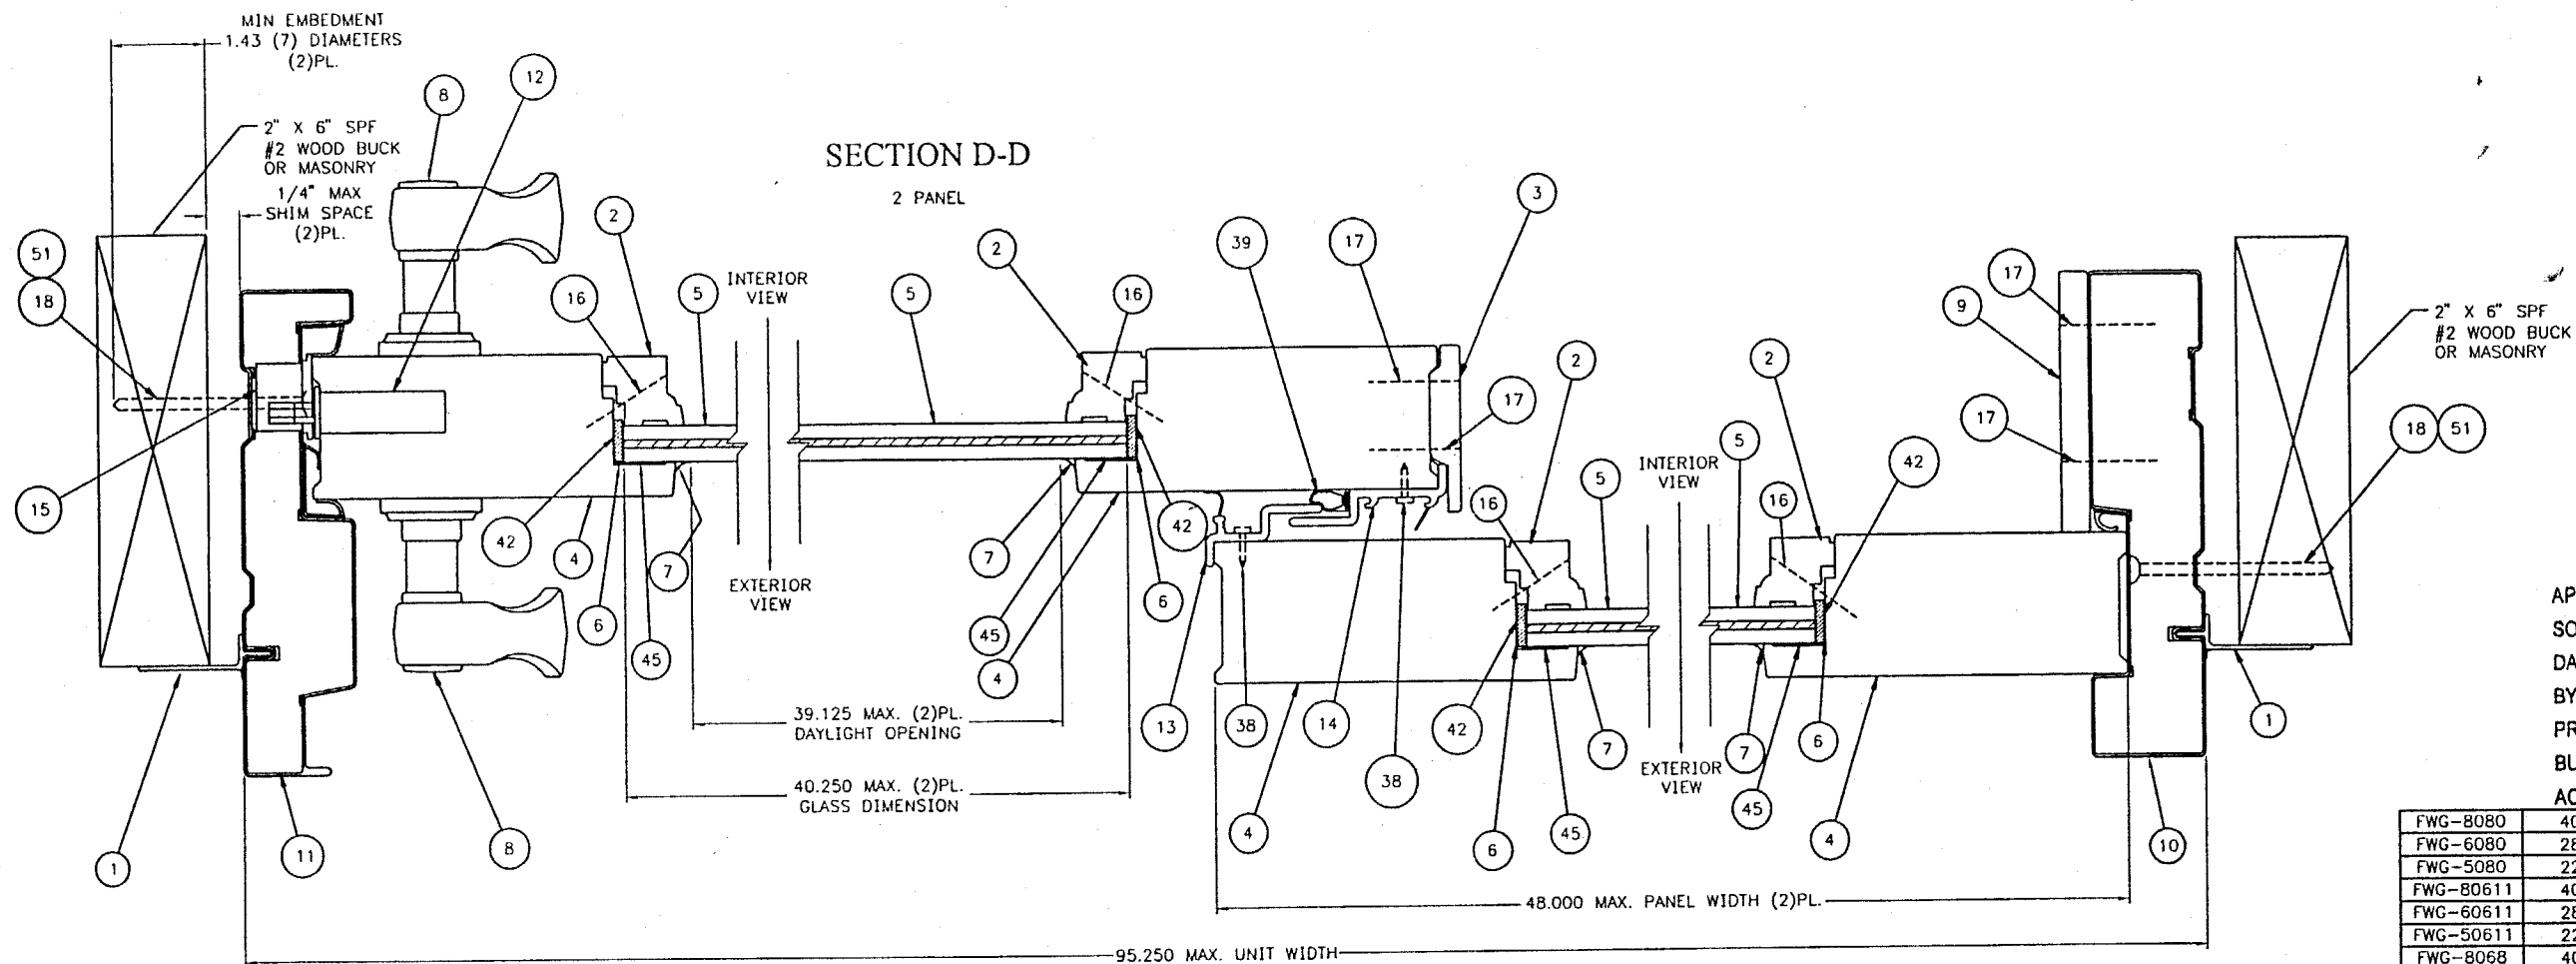

APPROVED AS COMPLYING WITH THE
SOUTH FLORIDA BUILDING CODE
DATE JUN 07 2001
BY Manuel Serr
PRODUCT CONTROL DIVISION
BUILDING CODE COMPLIANCE OFFICE
ACCEPTANCE NO. 00-1011.08

FWG-8080	40.250	39.125	95.250
FWG-6080	28.250	27.125	71.250
FWG-5080	22.250	21.125	59.250
FWG-80611	40.250	39.125	95.250
FWG-60611	28.250	27.125	71.250
FWG-50611	22.250	21.125	59.250
FWG-8068	40.250	39.125	95.250
FWG-6068	28.250	27.125	71.250
FWG-5068	22.250	21.125	59.250
FWG-4380	40.250	39.125	50.000
FWG-3380	28.250	27.125	38.000
FWG-2980	22.250	21.125	32.000
FWG-43611	40.250	39.125	50.000
FWG-33611	28.250	27.125	38.000
FWG-29611	22.250	21.125	32.000
FWG-4368	40.250	39.125	50.000
FWG-3368	28.250	27.125	38.000
FWG-2968	22.250	21.125	32.000
UNIT DES.	GLASS DIMENSION	DAYLIGHT OPENING	WIDTH
WIDTH DIMENSIONS			

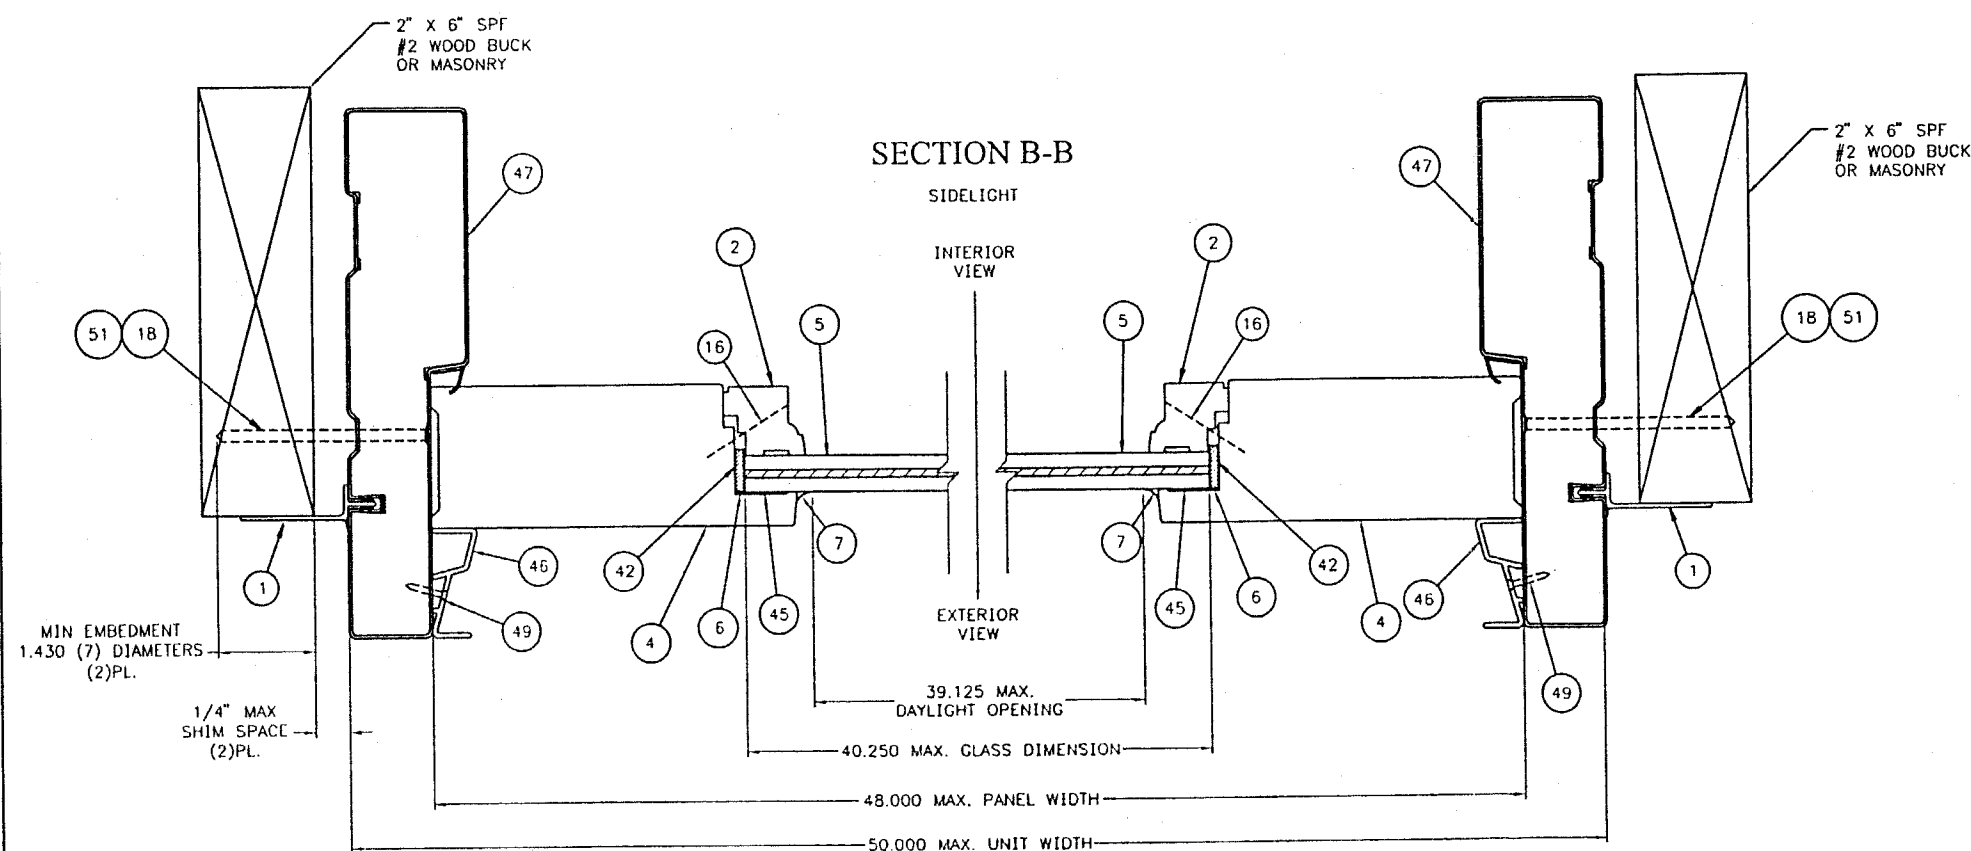

PRODUCT RENEWED
as complying with the Florida
Building Code
Acceptance No. 03-0415.17
Expiration Date JUNE 22, 2008
By Manuel Serr
Miami Dade Product Control
Division

TITLE
UNIT, FWG - IMPACT

Andersen Corporation
Bayport, Minnesota 55003

THESE DRAWINGS ARE PROVIDED AS A SERVICE BY ANDERSEN CORPORATION FOR THE
BENEFIT OF ITS CUSTOMERS. FINAL RESPONSIBILITY FOR ACCURACY OF DESIGN, FINAL
SPECIFICATIONS, DRAWINGS AND FOR THE ACTUAL INSTALLATION SUGGESTED BY THESE
DRAWINGS LIES WITH THE ARCHITECT, ENGINEER AND/OR CONTRACTOR.

COPYRIGHT ANDERSEN CORPORATION 1998. ALL RIGHTS RESERVED.



APPROVE/DATE
2/19/00

DRAWING NUMBER

DADE-FWG-IMPACT

SHT. 3 OF 4

B 4/25/00
A 2/19/99
REVISION

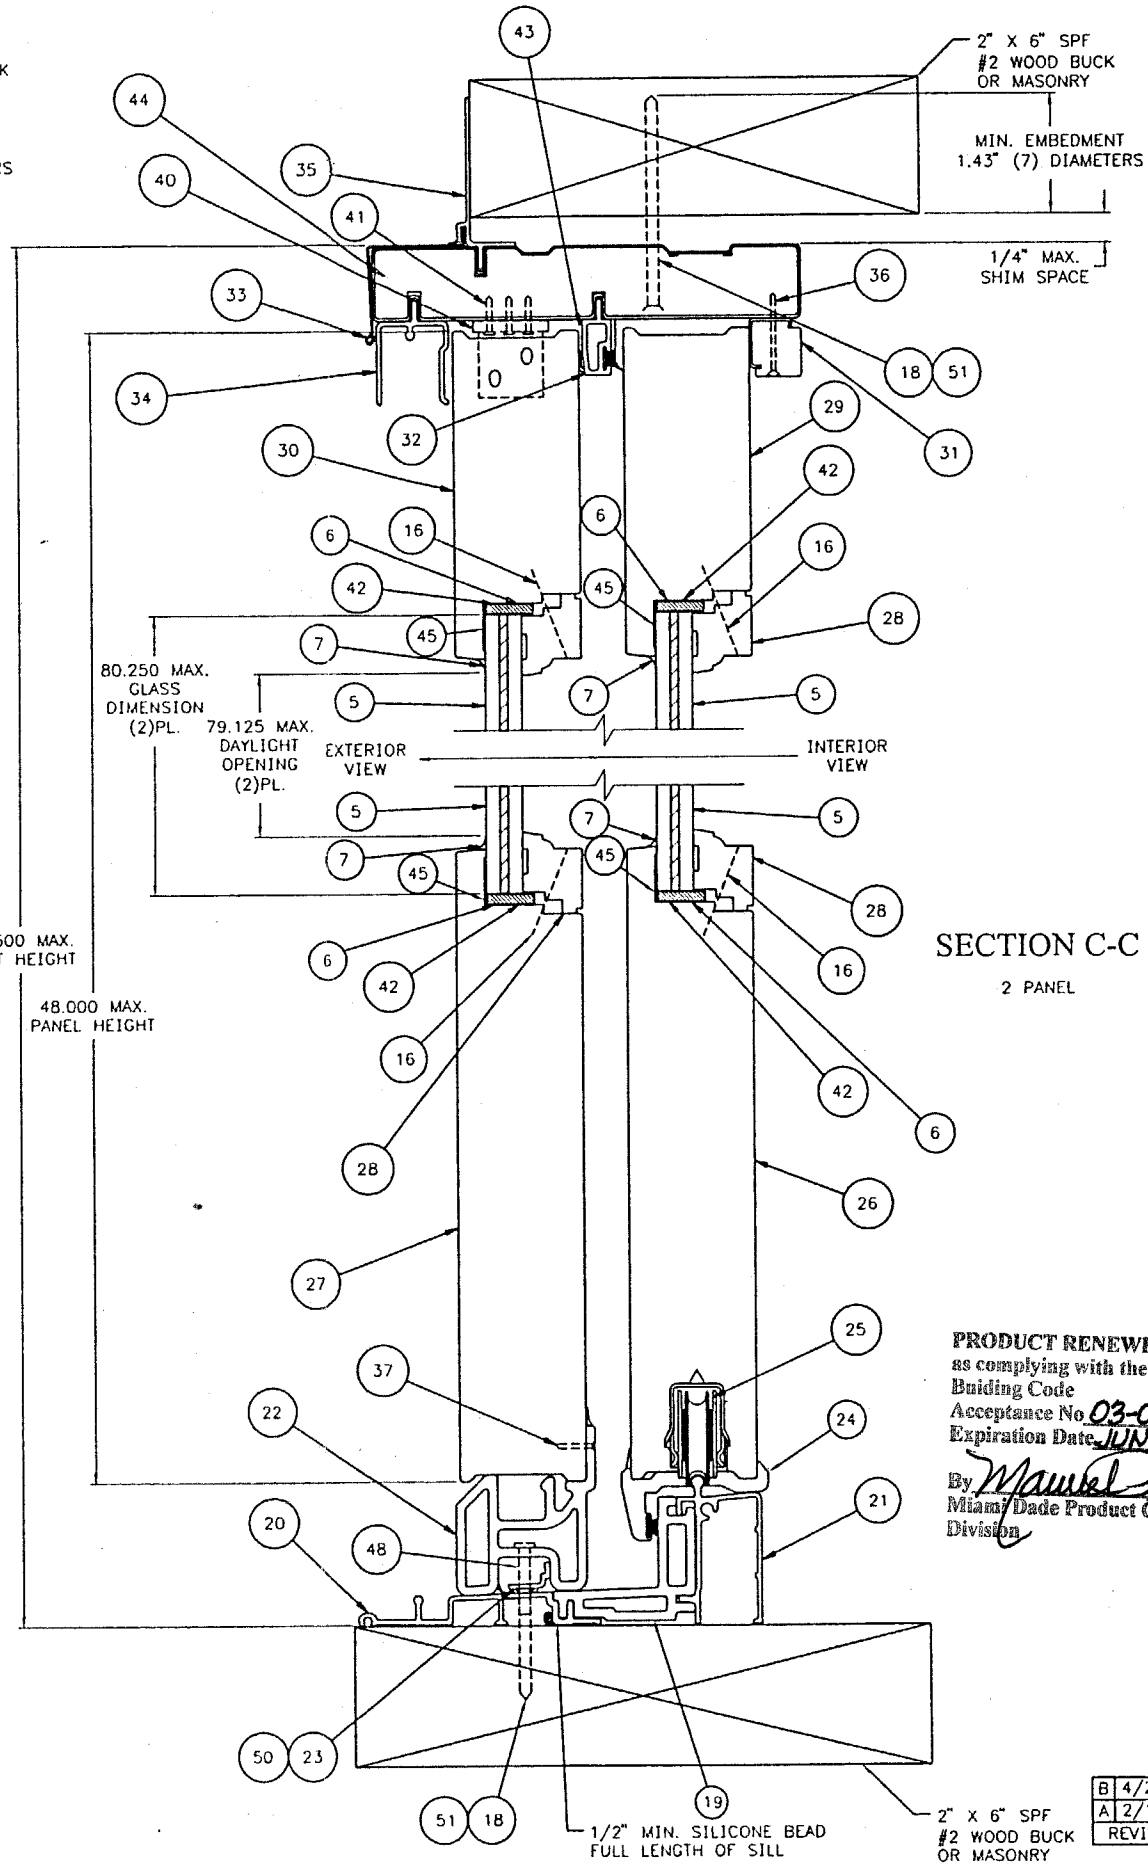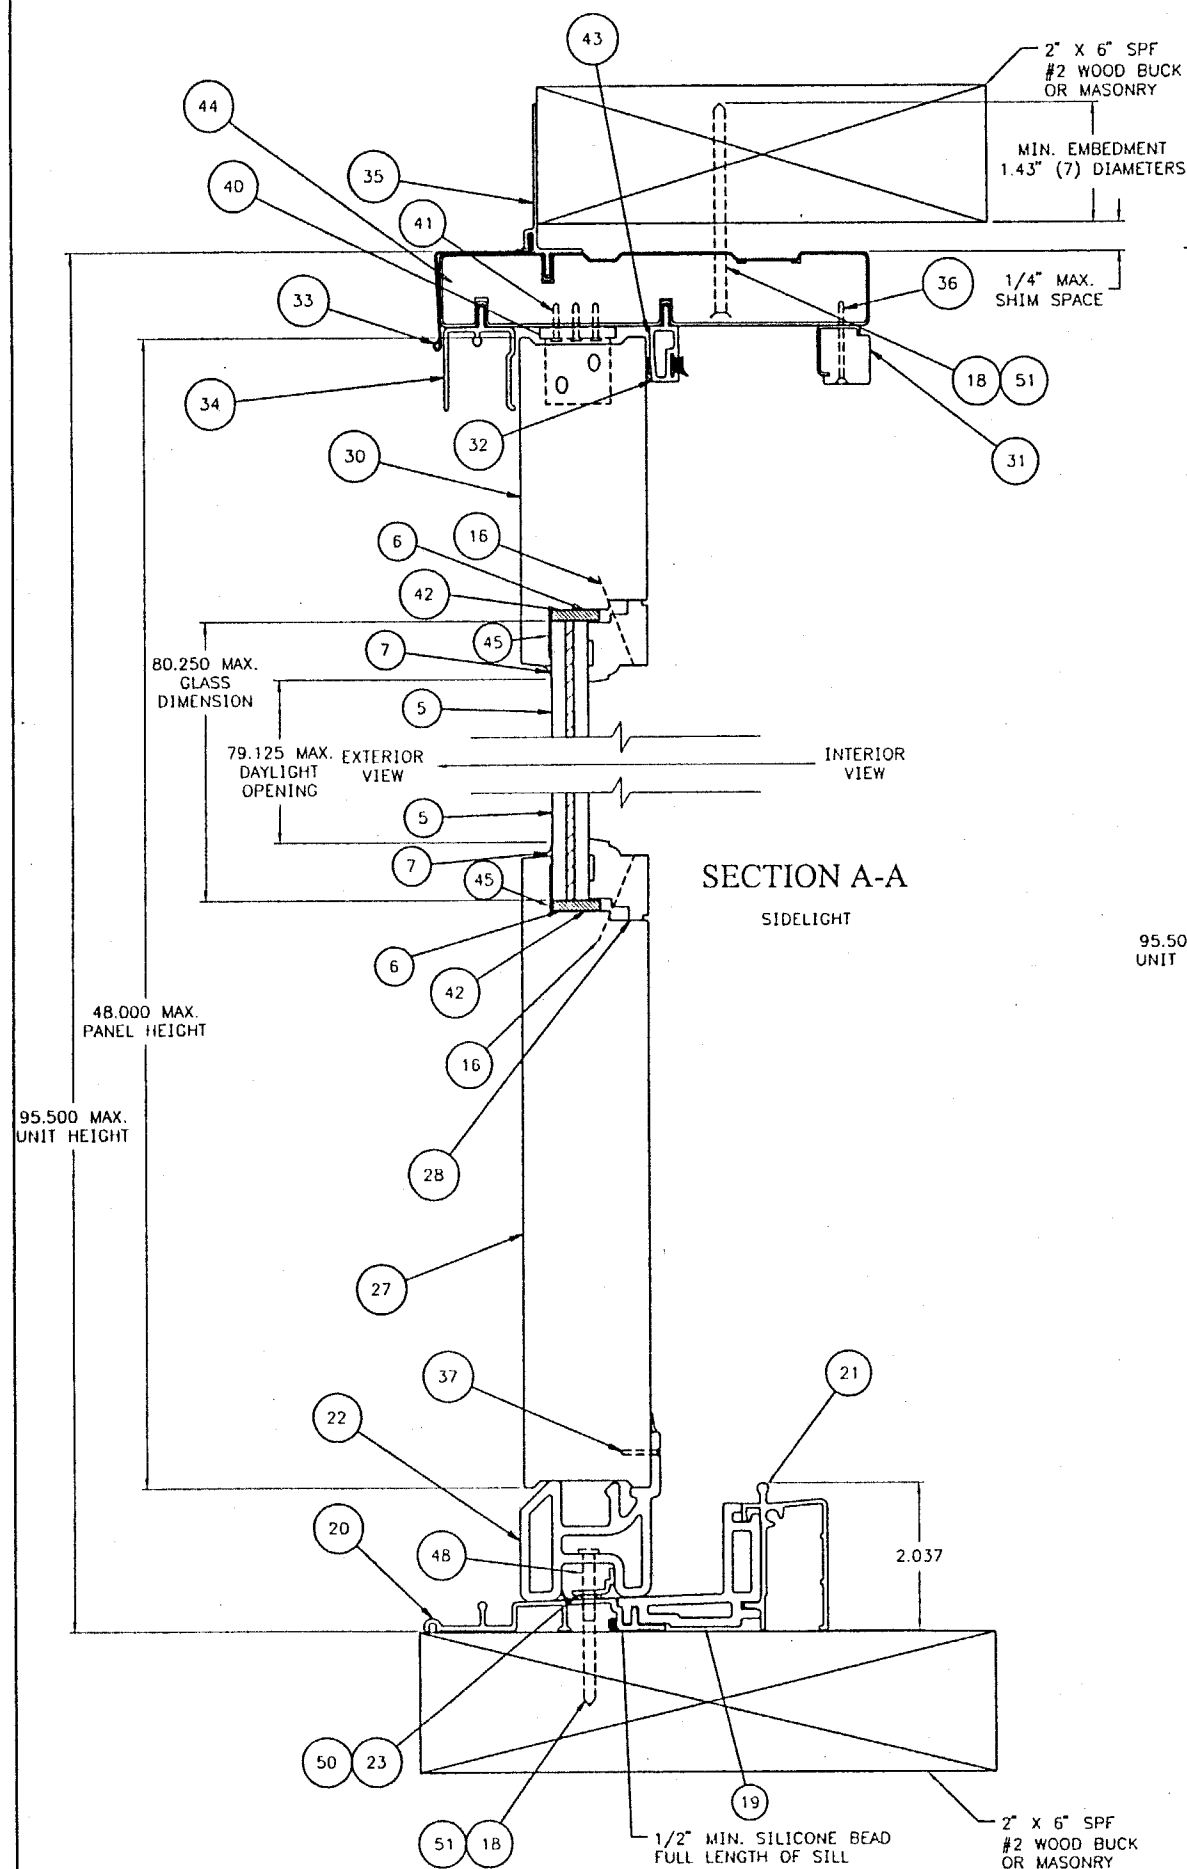

APPROVED AS COMPLYING WITH THE
SOUTH FLORIDA BUILDING CODE
DATE JUN 07 2001
BY Manuel Perez
PRODUCT CONTROL DIVISION
BUILDING CODE COMPLIANCE OFFICE
ACCEPTANCE NO. 00-1011.08

FWG-8080	80.250	79.125	95.500
FWG-6080	80.250	79.125	95.500
FWG-5080	80.250	79.125	95.500
FWG-80611	67.125	66.000	82.375
FWG-60611	67.125	66.000	82.375
FWG-50611	67.125	66.000	82.375
FWG-8068	64.250	63.125	79.500
FWG-6068	64.250	63.125	79.500
FWG-5068	64.250	63.125	79.500
FWG-4380	80.250	79.125	95.500
FWG-3380	80.250	79.125	95.500
FWG-2980	80.250	79.125	95.500
FWG-43611	67.125	66.000	82.375
FWG-33611	67.125	66.000	82.375
FWG-29611	67.125	66.000	82.375
FWG-4368	64.250	63.125	79.500
FWG-3368	64.250	63.125	79.500
FWG-2968	64.250	63.125	79.500
UNIT DES.	GLASS DIMENSION	DAYLIGHT OPENING	HEIGHT

PRODUCT RENEWED
as complying with the Florida
Building Code
Acceptance No. 03-0415.17
Expiration Date JUNE 22, 2008
By Manuel Perez
Miami Dade Product Control
Division

TITLE UNIT, FWG - IMPACT	
Andersen Corporation Bayport, Minnesota 55003	
THESE DRAWINGS ARE PROVIDED AS A SERVICE BY ANDERSEN CORPORATION FOR THE BENEFIT OF ITS CUSTOMERS. FINAL RESPONSIBILITY FOR ACCURACY OF DESIGN, FINAL SPECIFICATIONS, DRAWINGS AND FOR THE ACTUAL INSTALLATION SUGGESTED BY THESE DRAWINGS LIES WITH THE ARCHITECT, ENGINEER AND/OR CONTRACTOR.	
COPYRIGHT ANDERSEN CORPORATION 1998. ALL RIGHTS RESERVED.	
APPROVE/DATE 2/19/00	DRAWING NUMBER DADE-FWG-IMPACT
SHT. 4 OF 4	

B 4/25/00
A 2/19/99
REVISION